



**General Bid Bulletin No. 6**

**25 April 2022**

**PUBLIC BIDDING No. 22-001-9**

**Procurement of Package 1: Works Cebu South Bus Terminal (CSBT) to Capitol Urban Realm Enhancement (Link to the port)**

TO ALL PROSPECTIVE BIDDERS:

This General Bid Bulletin is issued to clarify/amend certain provisions in the Bidding Documents for the above-mentioned Project. Please refer to the table below for details:

**CLARIFICATIONS TO QUERIES**

ITEM NO.	BIDDING DOCUMENTS SECTION NO.	CLAUSE NO./ TITLE	PAGE NO.	QUERY/CLARIFICATIONS	FINAL RESPONSE
1	Part 1-Bidding Procedures, Section I. Instruction to Bidders and Section II. Bid Data Sheet Section IV. Bidding Forms	ITB Clause 10. Language of the Bid and C. Preparation of Bids BDS ITB 10.1 Bidding Forms Personnel Experience Equipment	10 & 28  85, 87 103-106 84	If the supporting documents are already in English, we would like to request for the clarification that whether the supporting documents of bidding forms shall be notarized and authenticated by the Philippine Embassy.  Besides, regarding the key personnel, construction experience and equipment, we would like to know which kind of supporting document shall bidder provide. Please specify the requirements on the supporting documents	If the supporting documents are already in English, there is no need to notarize the documents. However, if the English version is a direct translation of another language, the translation must be notarized.  With the consideration of the COVID pandemic, authentication of documents by the Philippine Embassy/Consulate may be solicited during the evaluation period.  Please see GBB 7 for the related amendment.  For the supporting documents, please refer to relevant Forms:

*[Handwritten signature]*

2	Part 1-Bidding Procedures. Section I. Instruction to Bidders & Section II. Bid Data Sheet Section IV. Bidding Forms	C BDS ITB Item 14.5 Bill of Quantities A. Preamble	28  54	It seems that the description of the preamble of BOQ is contradictory to the one of BDS ITB 14.5. We would like to request clarification that which clause will prevail.  Besides, we also would like to confirm the type of this contract, fixed lump sum price or fixed unit price, or other types?	Personnel – Form PER-1 Contractor's Representative and Key Personnel Schedule (p85), and PER-2 Resume and Declaration Contractor's Representative and key Personnel (p87)  Construction Experience - Form EXP – 4.1 General Construction Experience (p103), Form EXP – 4.2(a) Specific Construction and Contract Management Experience (p104), Form EXP – 4.2(b) Construction Experience in Key Activities (p106)  Equipment – Form EQU: Equipment (p84)
3	Part 1-Bidding Procedures, Section I. Instruction to Bidders	ITB Clause 14. Bid Prices and Discounts Item 14.7	13	Do you have a standard percentage for OCM, Profit and Taxes? If so, pls provide so we can comply.	There is no conflict between BOQ preamble and Bid Data Sheet ITB 14.5.  The type of contract is Unit Price.  There is no standard percentage for OCM, profit, and taxes. Payment and amount of taxes must be in accordance with the Philippine Government law.  Please refer to ITB 14 Bid Prices and Discounts 14.7 page 13.  "All duties, taxes, and other levies payable by the Contractor under the Contract, or for any other cause, as of the date 28 days prior to the deadline for submission of bids, shall be included in the rates and prices and the total Bid Price submitted by the Bidder."

4	Part 1-Bidding Procedures, Section I. Instruction to Bidders & Section II. Bid Data Sheet	ITB Clause 19. Bid Security Item 19.3 & BDS ITB 19.3(d)	15 & 29	For the Bid Security in a form of Security Bond, do you have a list of accredited agencies who can issue such bonds? If yes, please provide the list.	<p>There is no list but please refer to 19.3 of ITB 19. Bid Security, for the guidance as follows:</p> <p>If a bid security is specified pursuant to ITB 19.1, the bid security shall be a demand guarantee in any of the following forms at the Bidder's option:</p> <ul style="list-style-type: none"> <li>(a) an unconditional guarantee issued by a bank or financial institution (such as an insurance, bonding or surety company);</li> <li>(b) an irrevocable letter of credit;</li> <li>(c) a cashier's or certified check; or</li> <li>(d) another security specified in the BDS,</li> </ul> <p>from a reputable source from an eligible country. If the unconditional guarantee is issued by a financial institution located outside the Employer's Country, the issuing financial institution shall have a correspondent financial institution located in the Employer's Country to make it enforceable. In the case of a bank guarantee, the bid security shall be submitted either using the Bid Security Form included in Section IV, Bidding Forms, or in another substantially similar format approved by the Employer prior to bid submission. The bid security shall be valid for twenty-eight (28) days beyond the original validity period of the bid, or beyond any period of extension if requested under ITB 18.2."</p>
5	Part 1-Bidding Procedures, Section III. Evaluation and Qualification Criteria (Without Prequalification)	3. Qualification Item 2. Historical Contract Non-Performance	35-37	Are the following Declaration needed to be notarized? a. Historical Contract Non-Performance, Pending Litigation and Litigation History b. Environmental and Social Performance Declaration c. Sexual Exploitation and Abuse (SEA) and/or Sexual Harassment Performance Declaration	There is no need to notarize the said documents.

6	Part 1-Bidding Procedures. Section III. Evaluation and Qualification Criteria (Without Prequalification) Section IV. Bidding Forms	Form EXP – 4.2 (a) Form EXP – 4.2 (b)	104 106	For the Average Annual Construction Turnover, we have a number of projects under Department of Public Works and Highways of which provides us a Contractor Information of all DPWH Projects and provides us a summary of the Annual Construction Turn-over, can this suffice for DPWH Projects, or do we still need to attach the NOA, NTP, Contract and Certification of Completion? This is aside from our private projects, LGU projects and other agencies as different procuring entity.	Information from the DPWH registry is not sufficient to the DOTr requirements. Please provide the documents as requested in Section IV. Bidding Forms, Form EXP – 4.2(a) Specific construction and Contract Management Experience (p104) and Form EXP – 4.2(b) Construction Experience in key Activities (p106) as follows:  "Contractor to attach proof of experience such as contract award, relevant BOQ, notice to proceed (or equivalent) and contract completion certificate"
7	Part 1-Bidding Procedures, Section III. Evaluation and Qualification Criteria (without prequalification)	3. Qualification Item 4. Experience 4.2(a) "Specific Construction & Contract Management Experience.	38	A minimum number if similar contracts specified, what does it mean for similar contract? Please advise.	Similar contract pertains to PCCP Roads
8	Part 1-Bidding Procedures. Section III. Evaluation and Qualification Criteria (Without Prequalification)	3. Qualification Item 4. Experience 4.2b	39-40	Please clarify the exact definition of steelworks of the similar contract. We would like to confirm whether the steel bridge structure can be accepted as the steelworks of the similar contract? If not, please clarify the scope of the steelworks which can be accepted.	Steelworks refers to steel fabricated beams, girders, and columns. Steel bridge structures can be accepted as steelworks.
9	Part 1-Bidding Procedures. Section III. Evaluation and Qualification Criteria (Without Prequalification)	3. Qualification Item 4. Experience 4.2b	39-40	We would like to confirm if the steel structure can be calculated in tons or kg in the supporting documents from the bidder.	Steel structures can be calculated in tons or kg in the supporting documents from the bidders such as previous contract awards including BOQ and completion certificates.
10	Part 1-Bidding Procedures, Section III. Evaluation and Qualification Criteria (Without Prequalification)	3. Qualification Item 4. Experience 4.2(b)	40	"Laying of PCCP, Is the Employer accept a minimum construction experience for Asphalt Pavement instead of PCCP. Please advise	No, in accordance with 4.2(b) of Section III. Evaluation and Qualification Criteria (without prequalification)" which states "i. Laying of PCCP, with a volume of 4,465 cu.m."

11	Part 1-Bidding Procedures, Section III. Evaluation and Qualification Criteria (without prequalification)	3.5 Contractor's Representative and Key Personnel	42	<p>The Bidder shall provide details of the Contractor's Representative and Key Personnel and such other Key Personnel that the Bidder considers appropriate to perform the Contract, together with their academic qualifications and work experience. The Bidder shall complete the relevant Forms in Section IV, Bidding Forms.</p> <p>Please clarify the acceptable majors on the academic qualifications of the Accredited Material Engineer and Landscape Architect.</p>	<p>Please refer to Section VII, Works Requirements, Contractors Representative and Key Personnel, page 328 of the Bidding Documents.</p> <p style="text-align: center;">Section VII, Works Requirements 129</p> <p style="text-align: center;"><b>Contractor's Representative and Key Personnel</b></p> <table border="1" style="width: 100%; border-collapse: collapse;"> <thead> <tr> <th colspan="4" style="text-align: center;">Contractor's Representative and Key Personnel</th> </tr> <tr> <th style="width: 5%;">Item No.</th> <th style="width: 25%;">Position/Qualification</th> <th style="width: 30%;">Relevant academic qualifications</th> <th style="width: 40%;">Minimum years of relevant work experience</th> </tr> </thead> <tbody> <tr> <td>1</td> <td>Project Manager</td> <td>B.S. Civil Engineering degree</td> <td>5 with at least 3 years experience with the current employer (Bidder)</td> </tr> <tr> <td>2</td> <td>Project Engineer</td> <td>B.S. Civil Engineering degree</td> <td>3 with at least 3 years experience with the current employer (Bidder)</td> </tr> <tr> <td>3</td> <td>Accredited Materials Engineer</td> <td>B.S. Civil/Highway/Materials/Mechanics Engineering degree</td> <td>3</td> </tr> <tr> <td>4</td> <td>Highway/Road Engineer</td> <td>B.S. Civil Engineering degree</td> <td>3</td> </tr> <tr> <td>5</td> <td>Electrical Engineer</td> <td>B.S. Electrical Engineering degree</td> <td>3</td> </tr> <tr> <td>6</td> <td>Landscape Architect</td> <td>B.S. Architecture degree</td> <td>3</td> </tr>
12	Part 1-Bidding Procedures, Section IV. Bidding Forms	Daywork Schedule General, Daywork Labour, Daywork Materials, Daywork Contractor's Equipment	67-72	With regards to the Daywork Schedule, does this pertain to the per piece work?	<p>Yes, Daywork Schedule will be used for any new additional works that have not been accounted for in the BOQ or not captured in the Detailed Engineering Design.</p>																																
13	Part 1-Bidding Procedures, Section IV. Bidding Forms	A. Provisional Sums	72	For Page 72, Provisional Sums, it already states Php 22,000,000.00. Is this amount fixed and the contractor has the discretion as to the division of such amount for the following contingencies (station, miscellaneous works, allowance)?	<p>The provisional sum is fixed. The use of the provisional sum shall be upon the Engineer's determination and Employer's approval.</p>																																
14	Part 1-Bidding Procedures, Section IV. Bidding Forms	Form FIN 3.1: Financial Situation and Performance	98-99	On page 99, 2nd page of Financial Situation and Performance, sources of finance. It states to specify sources of finance to meet the cash flow requirements on works, what documents do we need to attach?	<p>Please refer to Section III Evaluation and Qualification Criteria (without prequalification), 3.1 Financial Capabilities.</p> <p>Please also refer to Section IV Bidding Forms. Form FIN -3.1: Financial Situation and Performance. Item 2 Financial Documents.</p> <p>"The Bidder and its parties shall provide copies of financial statements for last five (5) years (2016-2020) pursuant Section III, Evaluation and Qualifications Criteria, Sub-factor 3.1. The financial statements shall:</p>																																

76

15	Part 1-Bidding Procedures, Section IV. Bidding Forms	Form FIN 3.3: Financial Resources	101	On the Bidding documents page 101, Financial Resources, do we need to attach supporting documents or could the Audited Financial Statement suffice?	<p>(a) reflect the financial situation of the Bidder or in case of JV member, and not an affiliated entity (such as parent company or group member).</p> <p>(b) be independently audited or certified in accordance with local legislation.</p> <p>(c) be complete, including all notes to the financial statements.</p> <p>(d) correspond to accounting periods already completed and audited.</p> <p><input type="checkbox"/> Attached are copies of financial statements for the years required above; and complying with the requirements."</p> <p>Please refer to Section III. Evaluation and Qualification Criteria (without prequalification), Financial Situation and Performance 3.1 Financial Capabilities: "(iii) The audited balance sheets or, if not required by the laws of the Bidder's country, or other financial statement acceptable to the Employer, for the last five (5) years shall be submitted and must demonstrate current soundness of the Bidder's financial position and indicate its prospective long-term profitability", for the required documents.</p>
16	Part 1-Bidding Procedures, Section IV. Bidding Forms	Form EXP 4.2(b): Construction Experience in Key Activities	106	On Page 106, Form EXP 4.2. B -Construction Experience in Key Activities, Quantity-Percentage Participation and Actual Quantity Performed, we assume that this is the similar key activities that we need to meet, for the percentage participation, does this mean the weighted percentage based on the contract or the accomplished percentage on such specific work?	<p>The percentage refers to the portion of the work completed by the contractor.</p>
17	Part 2-Works Requirements, Section VII. Works Requirements	Special Specifications Part A - Facilities for the Engineer	123	Is there any requirement on the floor area of the field office for the engineer? Please advise	<p>Please refer to Section VII Works Requirements, Special Specification A.1.1(16) Provision of Combined Field Office and Living Quarters Building for the Engineer (Rental Basis)</p> <p>"The temporary building shall have a minimum floor area of 150 sqm. and the lot area shall be a minimum of 400 sqm. with parking provision for at least four (4) vehicles."</p>

18	Site Inspection	n/a	Due to the foregoing, we would like to request for your representative to assist us during the said site inspection and discussion regarding the result of said inspection.	A DOT Representative will assist. The Bidders may refer to GBB No. 3 for details regarding the site inspection.
19	Part 1-Bidding Procedures, Section I. Instruction to Bidders, Section II. Bid Data Sheet, Section IV. Bidding Forms	15,29, & 1.10	ITB Clause 19. Bid Security Item 19.3 & BDS ITB 19.3(d)	<p>Please refer to Section IV. Bidding Forms, Form of Bid Security (Demand Guarantee).</p> <p>The conditions for bid security using surety bond should be the same as the bank/demand guarantee.</p> <p>"At the request of the Applicant, we, as Guarantor, hereby irrevocably undertake to pay the Beneficiary any sum or sums not exceeding in total an amount of ( ) upon receipt by us of the Beneficiary's complying demand, supported by the Beneficiary's statement, whether in the demand itself or a separate signed document accompanying or identifying the demand, stating that either the Applicant:</p> <p>(a) has withdrawn its Bid prior to the Bid validity expiry date set forth in the Applicant's Letter of Bid, or any extended date provided by the Applicant; or</p> <p>(b) having been notified of the acceptance of its Bid by the Beneficiary prior to the expiry date of the Bid Validity or any extension thereto provided by the Applicant, (i) has failed to execute the contract agreement, or (ii) has failed to furnish the performance security and, if required, the Environmental and Social (ES) Performance Security, in accordance with the Instructions to Bidders ("ITB") of the Beneficiary's bidding document.</p> <p>This guarantee will expire: (a) if the Applicant is the successful bidder, upon our receipt of copies of the contract agreement signed by the Applicant and the performance security and, if required, the Environmental and Social(ES) Performance Security, issued to the Beneficiary in relation to such</p>

4

20	Summary of Bill of Quantities (BOQ), Item of Works	Bill Item No.1, Part B Other General Requirements	B.7 & B.14	We notice the "Unit" in the BOQ indicates "days" but the specification B.7.6 and B.14.5 method of measurement and basis of payment indicate "Month". Please clarify	contract agreement; or (b) if the Applicant is not the successful bidder, upon the earlier of (i) our receipt of a copy of the Beneficiary's notification to the Applicant of the results of the bidding process; or (ii) twenty-eight days after the expiry date of the Bid Validity.  Consequently, any demand for payment under this guarantee must be received by us at the office indicated above on or before that date."
21	Summary of Bill of Quantities (BOQ), Item of Works	Bill Item No.3 Part G Drainage and Slope Protection	404(1)a & 405(1)a2	1. Refer to the related drainage drawings of H. DRAINAGE SCHEDULE, the contractor shall be responsible for construction of catch basin, canal, drop inlet, manhole, and cleaning existing RCBC. There is no price item in BOQ. Please clarify.  2. The item 502(4)a5 in unpriced BOQ only includes manhole cover, please clarify. Refer to drainage plan No. G-0586, U-ditch drainage facilities are designed from Osmeña Boulevard to Port Area at Sta. 0+440 - Sta. 1+153.799. There is no price item in BOQ, please clarify.	<b>Please refer to the GBB No.7 Item No.1 for the Amended link of Bill of Quantities</b>  Unpriced BOQ Part G - Drainage and Slope Protection, Item 404(1)a and Item 405(1)a2.
22	Summary of Bill of Quantities (BOQ), Item of Works	Bill Item No.3, Part G Drainage and Slope Protection	502(1)a	We assumed that the Item 502(1)a-inlet, type 300mm dia. -in unpriced BOQ is the inlet of curb only, please clarify.	<b>Please refer to the GBB No.7 Item No.1 for the Amended link of Bill of Quantities</b>  Item 502(1)a should read as Inlets, Type 300mm diameter & catch basin.
23	Summary of Bill of Quantities (BOQ), Item of Works	Bill Item No.3 Part H Miscellaneous Structures	605(3)h1	We assumed that the specification of price item 605(3)h1 named Guide and Information Signs (Station Name/Post) is the drawing No. L04, pls. clarify.	Yes.

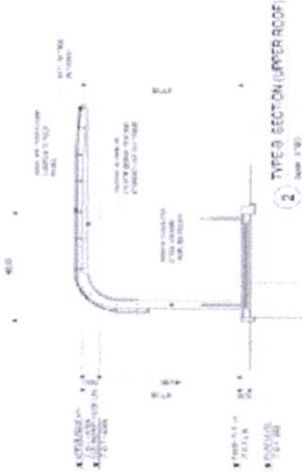


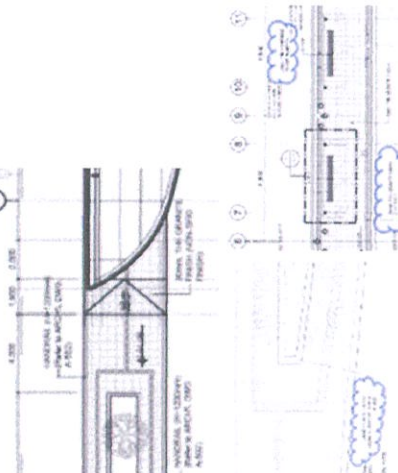
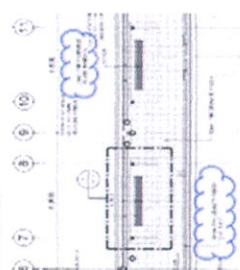
24	Summary of Bill of Quantities (BOQ), Item of Works	Bill Item No.4, & Bill Item No.5 Electrical Works, Building Structures (Bus Station) Part K & Part L (L.3)		Does the owner have a designated supplier or brand for electrical materials? Please advise	Any brand is acceptable as long as it complies with the required technical specification.  <b>Please refer to the GBB No.7 Item No.1 for the Amended link of Bill of Quantities</b>
25	Summary of Bill of Quantities (BOQ), Item of Works	Bill Item No.5, Part L.2 Miscellaneous Structures	711(1)	Is the specification of Price item 711(1) named station fence indicated in drawing No. L 03-barrier fence details, pls clarify?	Yes.
26	Summary of Bill of Quantities (BOQ), Item of Works	Bill Item No.5 Part L.2 Miscellaneous Structures	1003	Which item in the BOQ refers to Aluminum Louver referring to the drawing ST-CL-A-306.	<b>Please refer to the GBB No.7 Item No.1 for the Amended link of Bill of Quantities</b>
27	Summary of Bill of Quantities (BOQ), Item of Works	Bill Item No.5, Building Structures (Bus Station), Part L, L.3	1100	PART L (BOQ 1100) Provision for ATC-ITS pipe sleeve for cabling, bike lane signaling, & other related ancillary works. Please provide reference drawing details.	There is no reference drawing. Provision for ATC-ITS pipe sleeve for cabling, bike lane signaling, and other related ancillary works are subject to shop drawings.
28	Summary of Bill of Quantities (BOQ), Item of Works	Bill Item No.6, Landscaping Works, Item No. Part M	608(1)a	May we ask for the specifications or details of this item?	Item 608(1)a should read as Root Container, Polybag 600ml-900ml.  <b>Please refer to the GBB No.7 Item No.1 for the Amended link of Bill of Quantities</b>
29	Summary of Bill of Quantities (BOQ), Item of Works	Unpriced Bill of Quantities	n/a	For the Bill of Quantities, do we need to attach our detailed estimates?	There is no need to attach the detailed estimates.

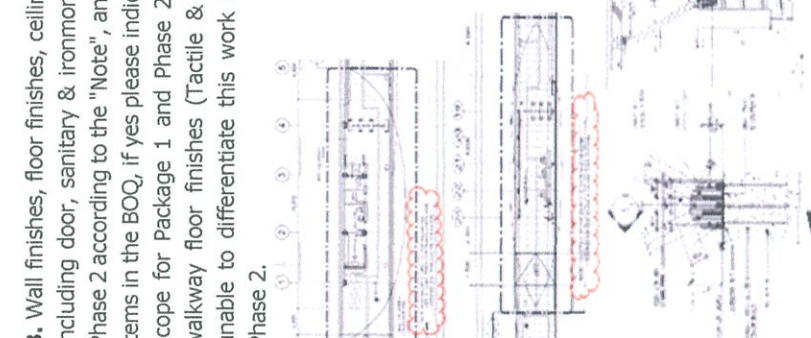
30	Official Drawings, N. Bus Station	Capitol, CNU, CSBT, and Fuente Station	ST-CL-A-001, ST-CNU-A-001, ST-FE-A-001, ST-SBT-A-001	Is the 30mm thick granite finish (DOT Type) under Phase 2 work, because no provision for this item in the BOQ.	The walkway floor finishes (Tactile and Granite Tiles) are under Package 1 as shown in the BOQ Part L.  <b>Please refer to the GBB No.7 Item No.1 for the Amended link of Bill of Quantities</b>
31	Official Drawings, L. Road Structures and Appurtenances	Guiding Post Type III Cantilever Type Gantry Detail A	L-02	With reference to drawing No.02, is the contractor's responsibility of supplying and installation of this type guiding post? Or drawing No. 02 is related with the price item 605(3) accordingly Guide and Information Signs, pls clarify.	All guide and information signs are the ones indicated in the Bill Item 3 Part H 605(3).  <b>Please refer to the GBB No.7 Item No.1 for the Amended link of Bill of Quantities</b>
32	Detailed Engineering Drawings	Complete Set of Drawings	n/a	May we also ask if you can provide the AutoCAD format for the steel structure for the bus stations?	AutoCAD format cannot be provided; instead a PDF file is available for all the drawings including the steel structure for the bus stations.  <b>Please refer to the GBB No.7 Item No.1 for the Amended link of Drawings</b>
33	Official Drawings, N. Bus Station	Capitol, Fuente, CNU, & CSBT Station	ST-CL-A-108, ST-CNU-A-108, ST-SBT-A-108, ST-FE-A-108	The drawing for the FRONT ELEVATION of Bus Station, we want to clarify the sliding screen door is automatic or manual?	The sliding screen door is not included in this Package.  <b>Please refer to the GBB No.7 Item No.1 for the Amended link of Drawings</b>
34	Official Drawings, N. Bus Station	Capitol, Fuente, CNU, & CSBT Station	n/a	Does the contractor provide air conditioner for bus station?	No, the contractor does not need to provide the air conditioner for the bus station as this is an open type bus station.  <b>Please refer to the GBB No.7 Item No.1 for the Amended link of Drawings</b>

76

35	Detailed Engineering Drawings	Complete Set of Drawings	n/a	Please provide a complete list of drawings. In the latest BOQ, there are a lot of Items we cannot find in the drawings. Please provide the latest bidding drawings, for example, Part C not complete, Part O, Part N, Part Q etc., we don't have drawings.	<b>Please refer to the GBB No.7 Item No.1 for the Amended link of Drawings</b>
36	Official Drawings, P. Electrical Plan	Panel Details (MDP-A)	P-42	We notice the MDP-A single line has branches 60AT/200AT, 2-Spares, however in the load schedule reflects 50 AT / 30 AT. Please advise if 50 AT is enough and clarify.	60AT/200AT shall be used for branch circuits of MAIN DISTRIBUTION PANEL- A (MDP-A) while 50AT/30AT for branch circuits of LIGHTING CONTROL PANEL-A (LCP-A). Both distribution circuits are enough to power each item.
37	Official Drawings, P. Electrical Plan	Load Schedule and Voltage Drop Calculation - MDP-D to Load Schedule and Voltage Drop Calculation - DPC-C1	P-52, P-56	We would also want to inquire about the voltage of road lighting, the voltage of lighting facilities in bus stations, and is there any communication requirement between bus stations?	Voltagers for the road lighting and bus station shall be 380V/ 230V 4-wires.  Please refer to Electrical Drawings No. P-52 to P-56. The communication requirement between bus stations is not included in Package 1.
38	Part 2, Section VII, Work Requirements	B.8.2.2 Traffic Control	150	No such table in the specification. Please advise.	<b>Please refer to the GBB No.7 Item No. 5 Amendment</b>
39	Part 2, Section VII, Work Requirements	B.8.2.4 Contractor's Liability and Responsibilities	153	No such table in the specification. Please advise	<b>Please refer to the GBB No.7 Item No. 6 Amendment</b>
40	Summary of Bill of Quantities (BOQ), Item of Works	Bill Item No.5 Part L.2 Miscellaneous Structures Item 1040(1), in the BOQ	1040 (1)	The description is referring to which item in the drawing.	<b>Please refer to the GBB No.7 Item No.1 for the Amended link of Drawings</b>  For the details of the 25mm thick metal plate please refer to Bus Station - Structural Drawings - Sheet No. ST-CL-14.

41	Summary of Bill of Quantities (BOQ), Item of Works	Bill Item No.5 Part L.2 Miscellaneous Structures	1040 (1)	 <p>Which drawing is referring to synthetic wood benches, 25mm thick metal plate?</p>	<p><b>Please refer to the GBB No.7 Item No. 1 for the Amended link of Bill of Quantities and GBB No. 7 Item No.4 for the Amendment</b></p>
42	Summary of Bill of Quantities (BOQ), Item of Works	Bill Item No.5 Part L.2 Miscellaneous Structures	1040 (1)	Metal letter for station nameplate?	<p><b>Please refer to the GBB No.7 Item No.1 for the Amended link of Drawings</b></p> <p>For Bus Station Architectural Drawings Sheet No. ST-CNU-A-307 metal letter for station nameplate.</p>
43	Summary of Bill of Quantities (BOQ), Item of Work	Bill Item No.5 Part L.2 Miscellaneous Structures	1002	Please advise and clarify the following; (1) Specification of pipe materials for cold water supply 25mm Diameter. And Sewer & Vent, Rainwater pipe (2) To Confirm the Water meter is part of the work scope.	<p><b>Please refer to the GBB No.7 Item No.1 for the Amended link of Drawings</b></p> <p><u>Drainage and Plumbing Specification</u></p> <p>This is to confirm that water meter will not be a part of Package 1</p>
44	Summary of Bill of Quantities (BOQ), Item of Works	Bill Item No.5 Part L.3 Electrical Works at the Station	1202	Please advise for Specification of Fire Alarm Detection/Suppressant System, including sensors & switches	<p><b>Please refer to the GBB No.7 Item No.8 for the Amendment of Fire Alarm-Suppressant Specification.</b></p>

45	Official Drawings, N. Bus Station	Capitol, CNU, CSBT and Fuente Station	<p>ST-CL-A-101, ST-CL-A-103, ST-CL-A-201, ST-CL-A-306, ST-CL-A-502, ST-CL-404</p> <p>Is the 12mm thick tempered glass handrail under Phase 2 work, because no provision for this item in the BOQ and did not mention in the drawing that this is under Phase 2.</p> <p>We are unable to find the detail for "Handrail (H=1200mm) Refer to ARCH'L DWG. A-502) and is this work under Phase 2 because no provision for this item in the BOQ</p> 	<p>The handrail is not included in Package 1. This work is under Phase 2. The contractor is not required to bid for Phase 2.</p> <p><b>Please refer to the GBB No.7 Item No.1 for the Amended link of Drawings.</b></p>
46	Official Drawings, N. Bus Station	Capitol, CNU, CSBT and Fuente Station	<p>ST-CL-A-502</p> <p>The drawing shows a stainless steel (sst) bench on drawing ST-CL-A-502, but the BOQ has no provision for this SST Bench, Part L BOQ item 1040(1) shows synthetic wood benches.</p> 	<p>Item 1040(1) should read as:</p> <p>"All ancillary works including but not limited to bolts, washers, nuts, gusset plates, stiffeners, fasteners, <b>stainless steel benches</b>, 25mm thick metal plates, metal letters for the station nameplates etc."</p> <p>in Bill Item No. 5 Part L.2 Miscellaneous Structures.</p> <p><b>Please refer to the GBB No.7 Item No.1 for the Amended link of Bill of Quantities.</b></p>
47	Official Drawings, N. Bus Station	Capitol, Fuente, CNU, & CSBT Station	<p>ST-CL-1 to ST-CL-2 &amp; ST-CL-12 to ST-CL-13</p> <p>Is the structural steel frame at Grid 1-4 and Grid 19-23 under Phase 2 works, if yes what is the scope for Package 1 contractor in association with this steel structure, as the BOQ has no provision for this structure steel frame and associate work.</p>	<p>The superstructure of structural steel frame at Grid 1-4 and Grid 19-23 are under Phase 2 works closed station design.</p> <p>However, please note that the substructure of structural components at Grid 1-4 and Grid 19-23 such as footing, tie-beam and other related components are included in the scope of works of Package 1.</p>

48	<p>Official Drawings, N. Bus Station</p> <p>Capitol, CNU, CSBT, and Fuente</p> <p>Architecture drawing</p> <p>"Note: Ticketing Office (Grid 1-4), Ticketing Machine (Grid 19-23) Including Floor Finishes, Screen Door, Turnstiles are Phase 2. (Close Type Station) and Structure drawing no. ST-CL-3, ST-CL-13, ST-CL-14, ST-CL-15, ST-CL-A-401</p> <p>Reference to these drawings what are the Package 1 contractor scope of work within these Gridline 1-4 and 19-23. Please advise and clarify the following</p>	<p>Capitol, Fuente, CNU, &amp; CSBT Station</p>	<p>ST-CL-3, ST-CL-13, ST-CL-14, ST-CL-15, ST-CL-A-401</p>	<p>1. When is the Phase 2 start date, as the contractor requires to incorporate Phase 2 work into the program?</p> <p>2. The ANNEX-1 attached herewith, the drawing for the FRONT ELEVATION of Bus Station, we want to clarify the sliding screen door is automatic or manual?</p> <p>3. Wall finishes, floor finishes, ceiling finishes and partition including door, sanitary &amp; ironmongery fittings are under Phase 2 according to the "Note", and no provision for these items in the BOQ, if yes please indicate on the drawing the scope for Package 1 and Phase 2, because for example walkway floor finishes (Tactile &amp; Granite tiles), we are unable to differentiate this work is under Package 1 or Phase 2.</p>	<p>The contractor is not required to bid for Phase 2. This is only indicated for reference purposes only.</p> <p><b>Please refer to the GBB No.7 Item No.1 for the Amended link of Drawings.</b></p> 
----	---	---	---	---	--

49	Official Drawings, N. Bus Station	Capitol, Fuente, CNU, & CSBT Station	ST-CL-A-001, ST-CNU-A-001, ST-FE-A-001, ST-SBT-A-001	Is the walkway floor finishes (Tactile & Granite tiles) under Phase 2, because the "Note" for Phase 2 mentioned "Floor Finishes" is under Phase 2? if yes please indicate on the drawing the scope for Package 1 and Phase 2.	The walkway floor finishes (Tactile and Granite Tiles) are under Package 1.  <b>Please refer to the GBB No.7 Item No.1 for the Amended link of Bill of Quantities</b> Bill Item No.5 Part L.2 Miscellaneous
50	Official Drawings, N. Bus Station	Capitol, Fuente, CNU, & CSBT Station	ST-CL-A-502, ST-CNU-A-502, ST-FE-A-502, ST-SBT-A-502	We are unable to find the details for "Landscape Curb (Refer to ARCH'L DWG. A-502).	<b>Please refer to the GBB No.7 Item No.1 for the Amended link of Drawings.</b>
51	Official Drawings, N. Bus Station	Capitol, Fuente, CNU, & CSBT Station	ST-CL-A-308, ST-CNU-A-308, ST-FE-A-308, ST-SBT-A-308	We are unable to find the detail of "Concrete Kassel Curb" shown in the BOQ Item 600(4)a and the location of the said curb.	Concrete Berthing Curb indicated in the drawing should read as "Concrete Kassel Curb".  <b>Please refer to the GBB No.7 Item No.1 for the Amended link of Drawings.</b>
52	Official Drawings, L. Roads Structures & Appurtenances	Roads Structures & Appurtenances  Roads Structures & Appurtenances, Drawing No. L-01 and BOQ PART H Item 625(3)a2a and 625(3)a2b.	L-01	This drawing only shows one type of Bollards but BOQ shows 2 types of Bollards. Please clarify.	Please refer to the revised drawing which includes type 2 bollard Drawing No. OD 119.  <b>Please refer to the GBB No.7 Item No.1 for the Amended link of Drawings</b> <u>Type 2 Bollard</u>
53	Official Drawings, T. Fire Hydrant Detail Schedule	Fire Hydrant Detail Schedule	T-01 to T-04	As stated in drawings No. T01-04, there will be 21 fire hydrants installed, but no price item in BOQ, pls clarify.	<b>Please refer to the GBB No.7 Item No.1 for the Amended link of Drawings</b> <u>Fire Hydrant</u>  The contractor is not required to submit a bid for the Fire Hydrants. These drawings are for reference only and not included in Package 1.

54	Official Drawings, D. Typical Cross Section	Typical Sidewalk Cross Section	D11-D12	Provision for Embedded Utilities	Additional Drawing for Typical Cross Section showing the provision for the utilities.  <b>Please refer to the GBB No.7 Item No.1 for the Amended link of Drawings</b> <u>Typical Cross Section with Utilities.</u>
----	---	--------------------------------	---------	----------------------------------	---

For your guidance and information

  
**SIGNATURE REDACTED**  
**PAUL JASPER V. DE GUZMAN**  
 Chairperson

*For the purpose of this Bulletin and for better understanding of its contents, the following rules shall apply: (a) Double Strike out – denotes deletion; (b) Underline – denotes inclusion or new item/requirement; and "xxx" – denotes separation of phrase/s being amended from the rest of the main text*